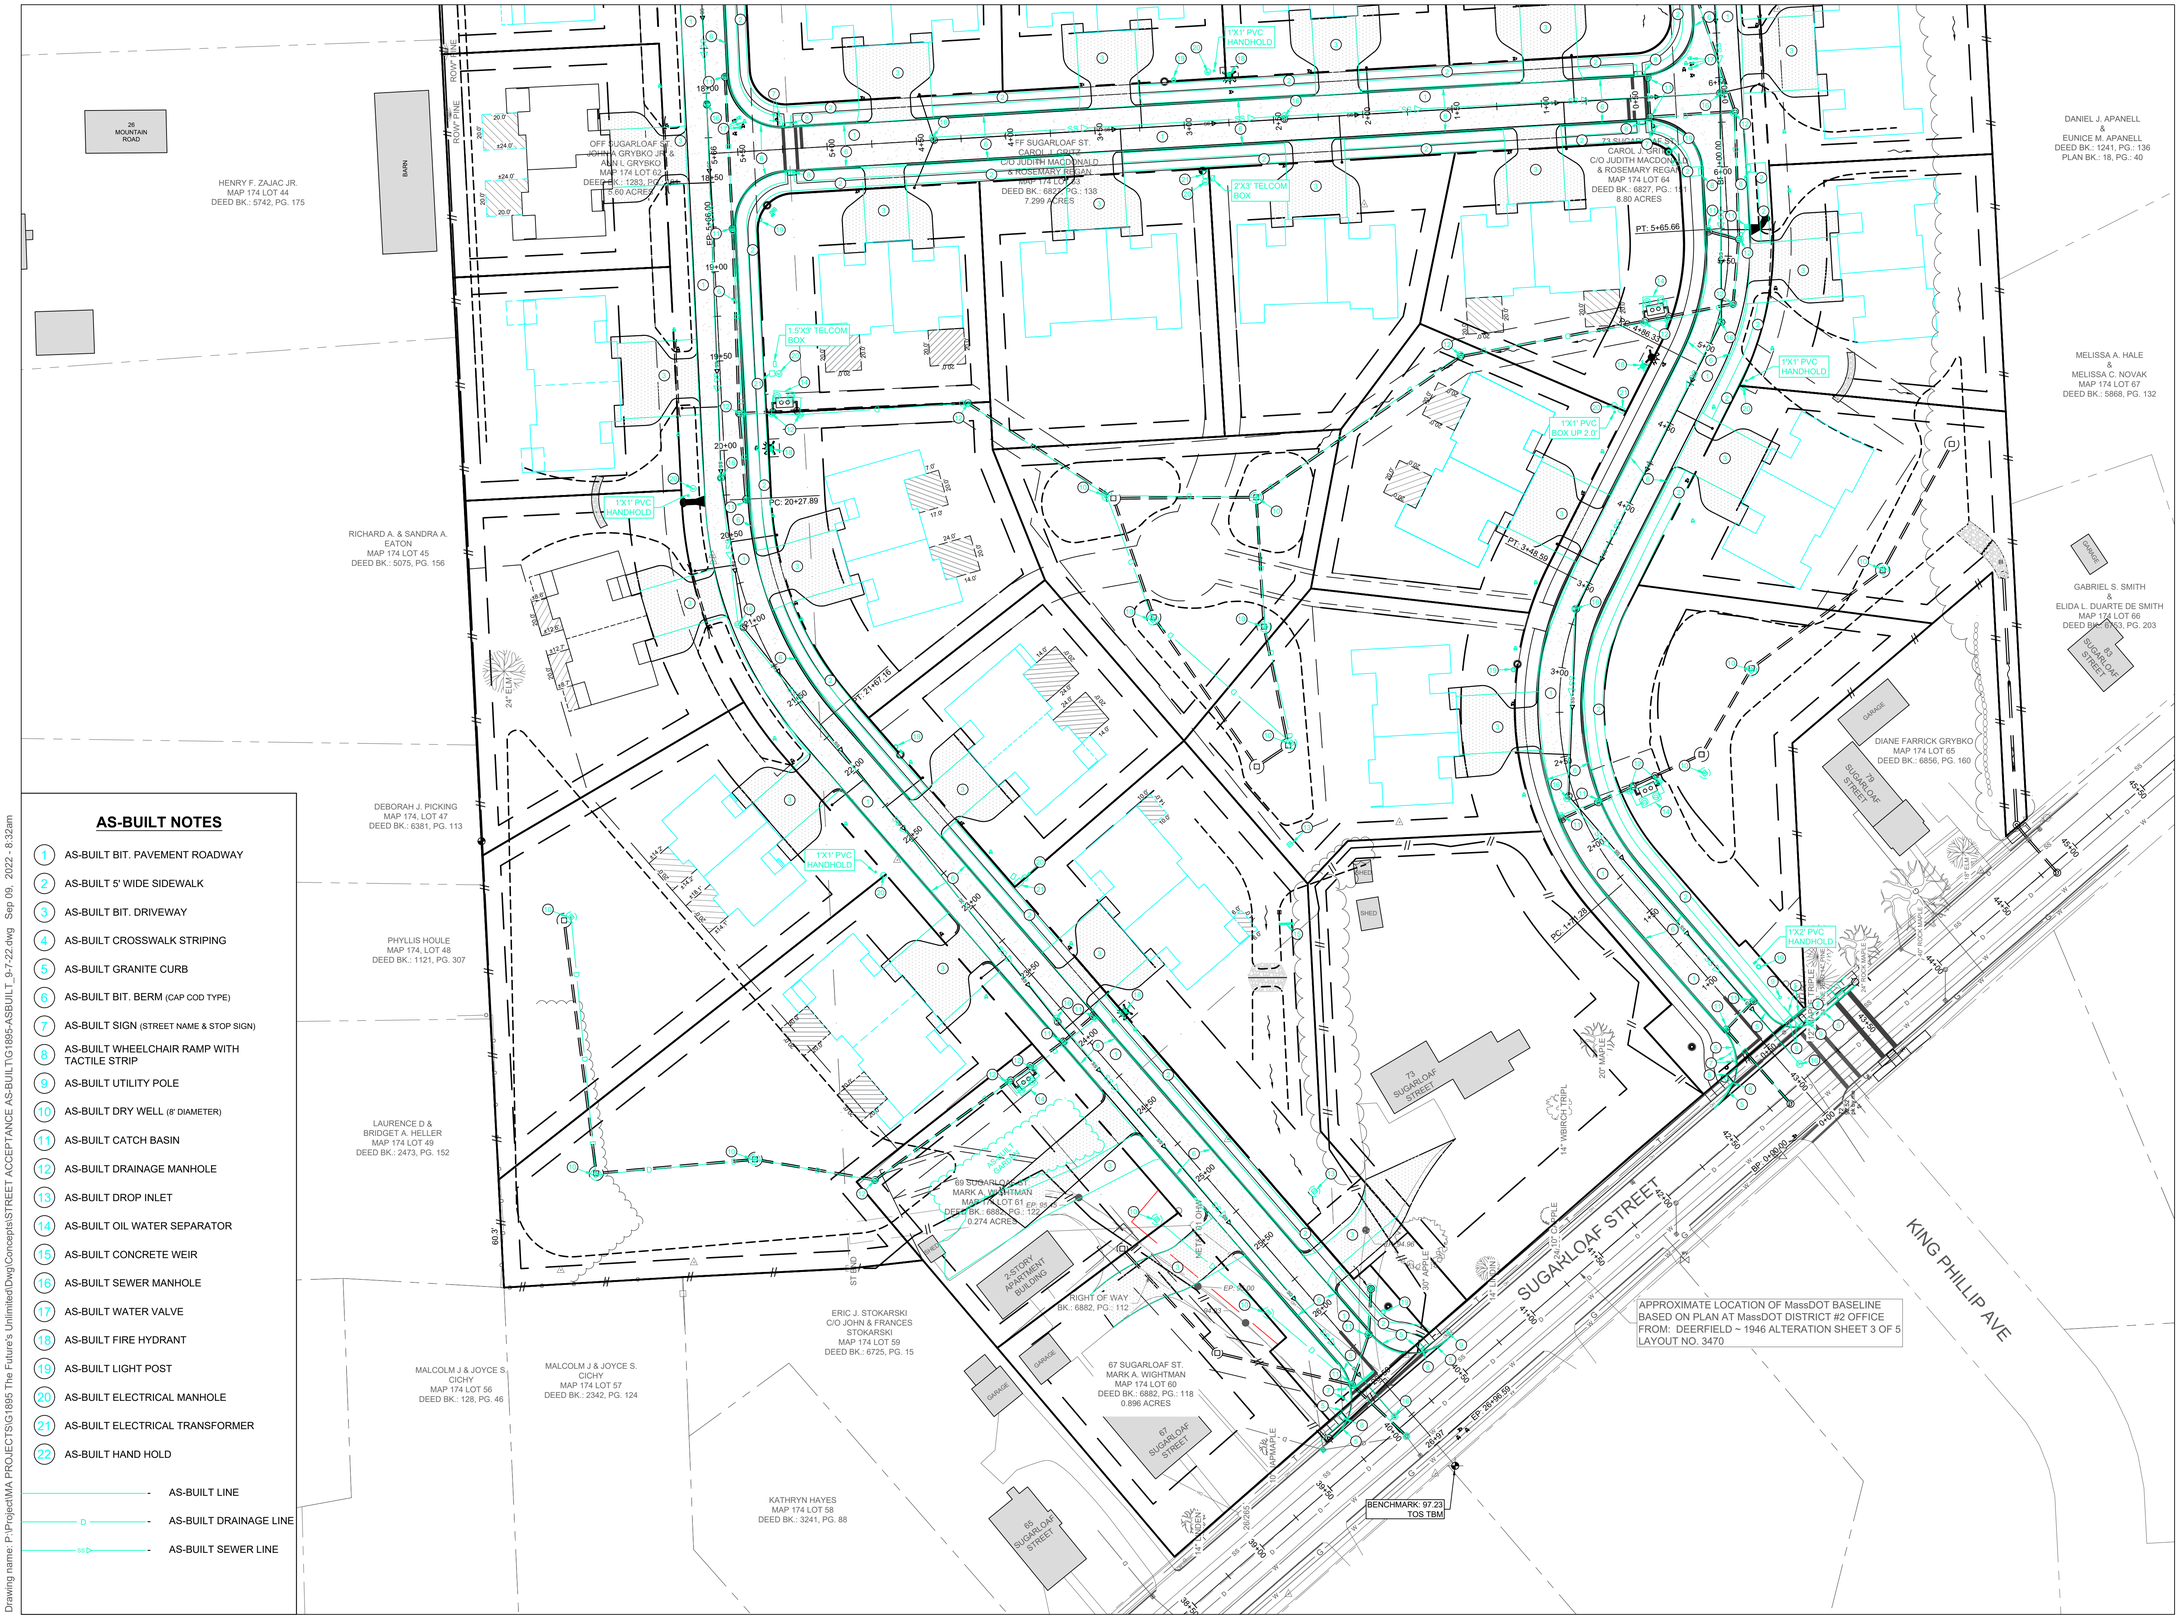

AS-BUILT NOTES

1. AS-BUILT BIT. PAVEMENT ROADWAY
2. AS-BUILT 5' WIDE SIDEWALK
3. AS-BUILT BIT. DRIVEWAY
4. AS-BUILT CROSSWALK STRIPING
5. AS-BUILT GRANITE CURB
6. AS-BUILT BIT. BERM (CAP COD TYPE)
7. AS-BUILT SIGN (STREET NAME & STOP SIGN)
8. AS-BUILT WHEELCHAIR RAMP WITH TACTILE STRIP
9. AS-BUILT UTILITY POLE
10. AS-BUILT DRY WELL (8' DIAMETER)
11. AS-BUILT CATCH BASIN
12. AS-BUILT DRAINAGE MANHOLE
13. AS-BUILT DROP INLET
14. AS-BUILT OIL WATER SEPARATOR
15. AS-BUILT CONCRETE WEIR
16. AS-BUILT SEWER MANHOLE
17. AS-BUILT WATER VALVE
18. AS-BUILT FIRE HYDRANT
19. AS-BUILT LIGHT POST
20. AS-BUILT ELECTRICAL MANHOLE
21. AS-BUILT ELECTRICAL TRANSFORMER
22. AS-BUILT HAND HOLD

- AS-BUILT LINE
- D - AS-BUILT DRAINAGE LINE
- SS - AS-BUILT SEWER LINE

Drawing name: P:\Project\MA PROJECTS\G1695 The Future's Unlimited\Dwg\Concepts\STREET ACCEPTANCE AS-BUILT\G1695-ASBUILT_9-7-22.dwg Sep 09, 2022 - 8:32am

DRAFT

NOT FOR CONSTRUCTION

NO.	REVISION	DATE	DWN	CHK

SVE ©2019

Engineering
Planning
Landscape Architecture
Surveying

SVE Associates
P.O. Box 1818
439 West River Road
Brattleboro, VT 05302
T 413.774.6698
F 413.773.0875
www.sveassoc.com

INTERIM HORIZONTAL AS-BUILT PLAN

THE CONDOMINIUMS AT SUGARLOAF

THE FUTURES UNLIMITED
7 OAK KNOLL DRIVE
SOUTH DEERFIELD, MA 01373

0 20 40 80
GRAPHIC SCALE 1" = 20'

N

PROJ. #: G1895

DATE: 8 - SEP - 22

DRAWN: MJS

SHEET 1/2

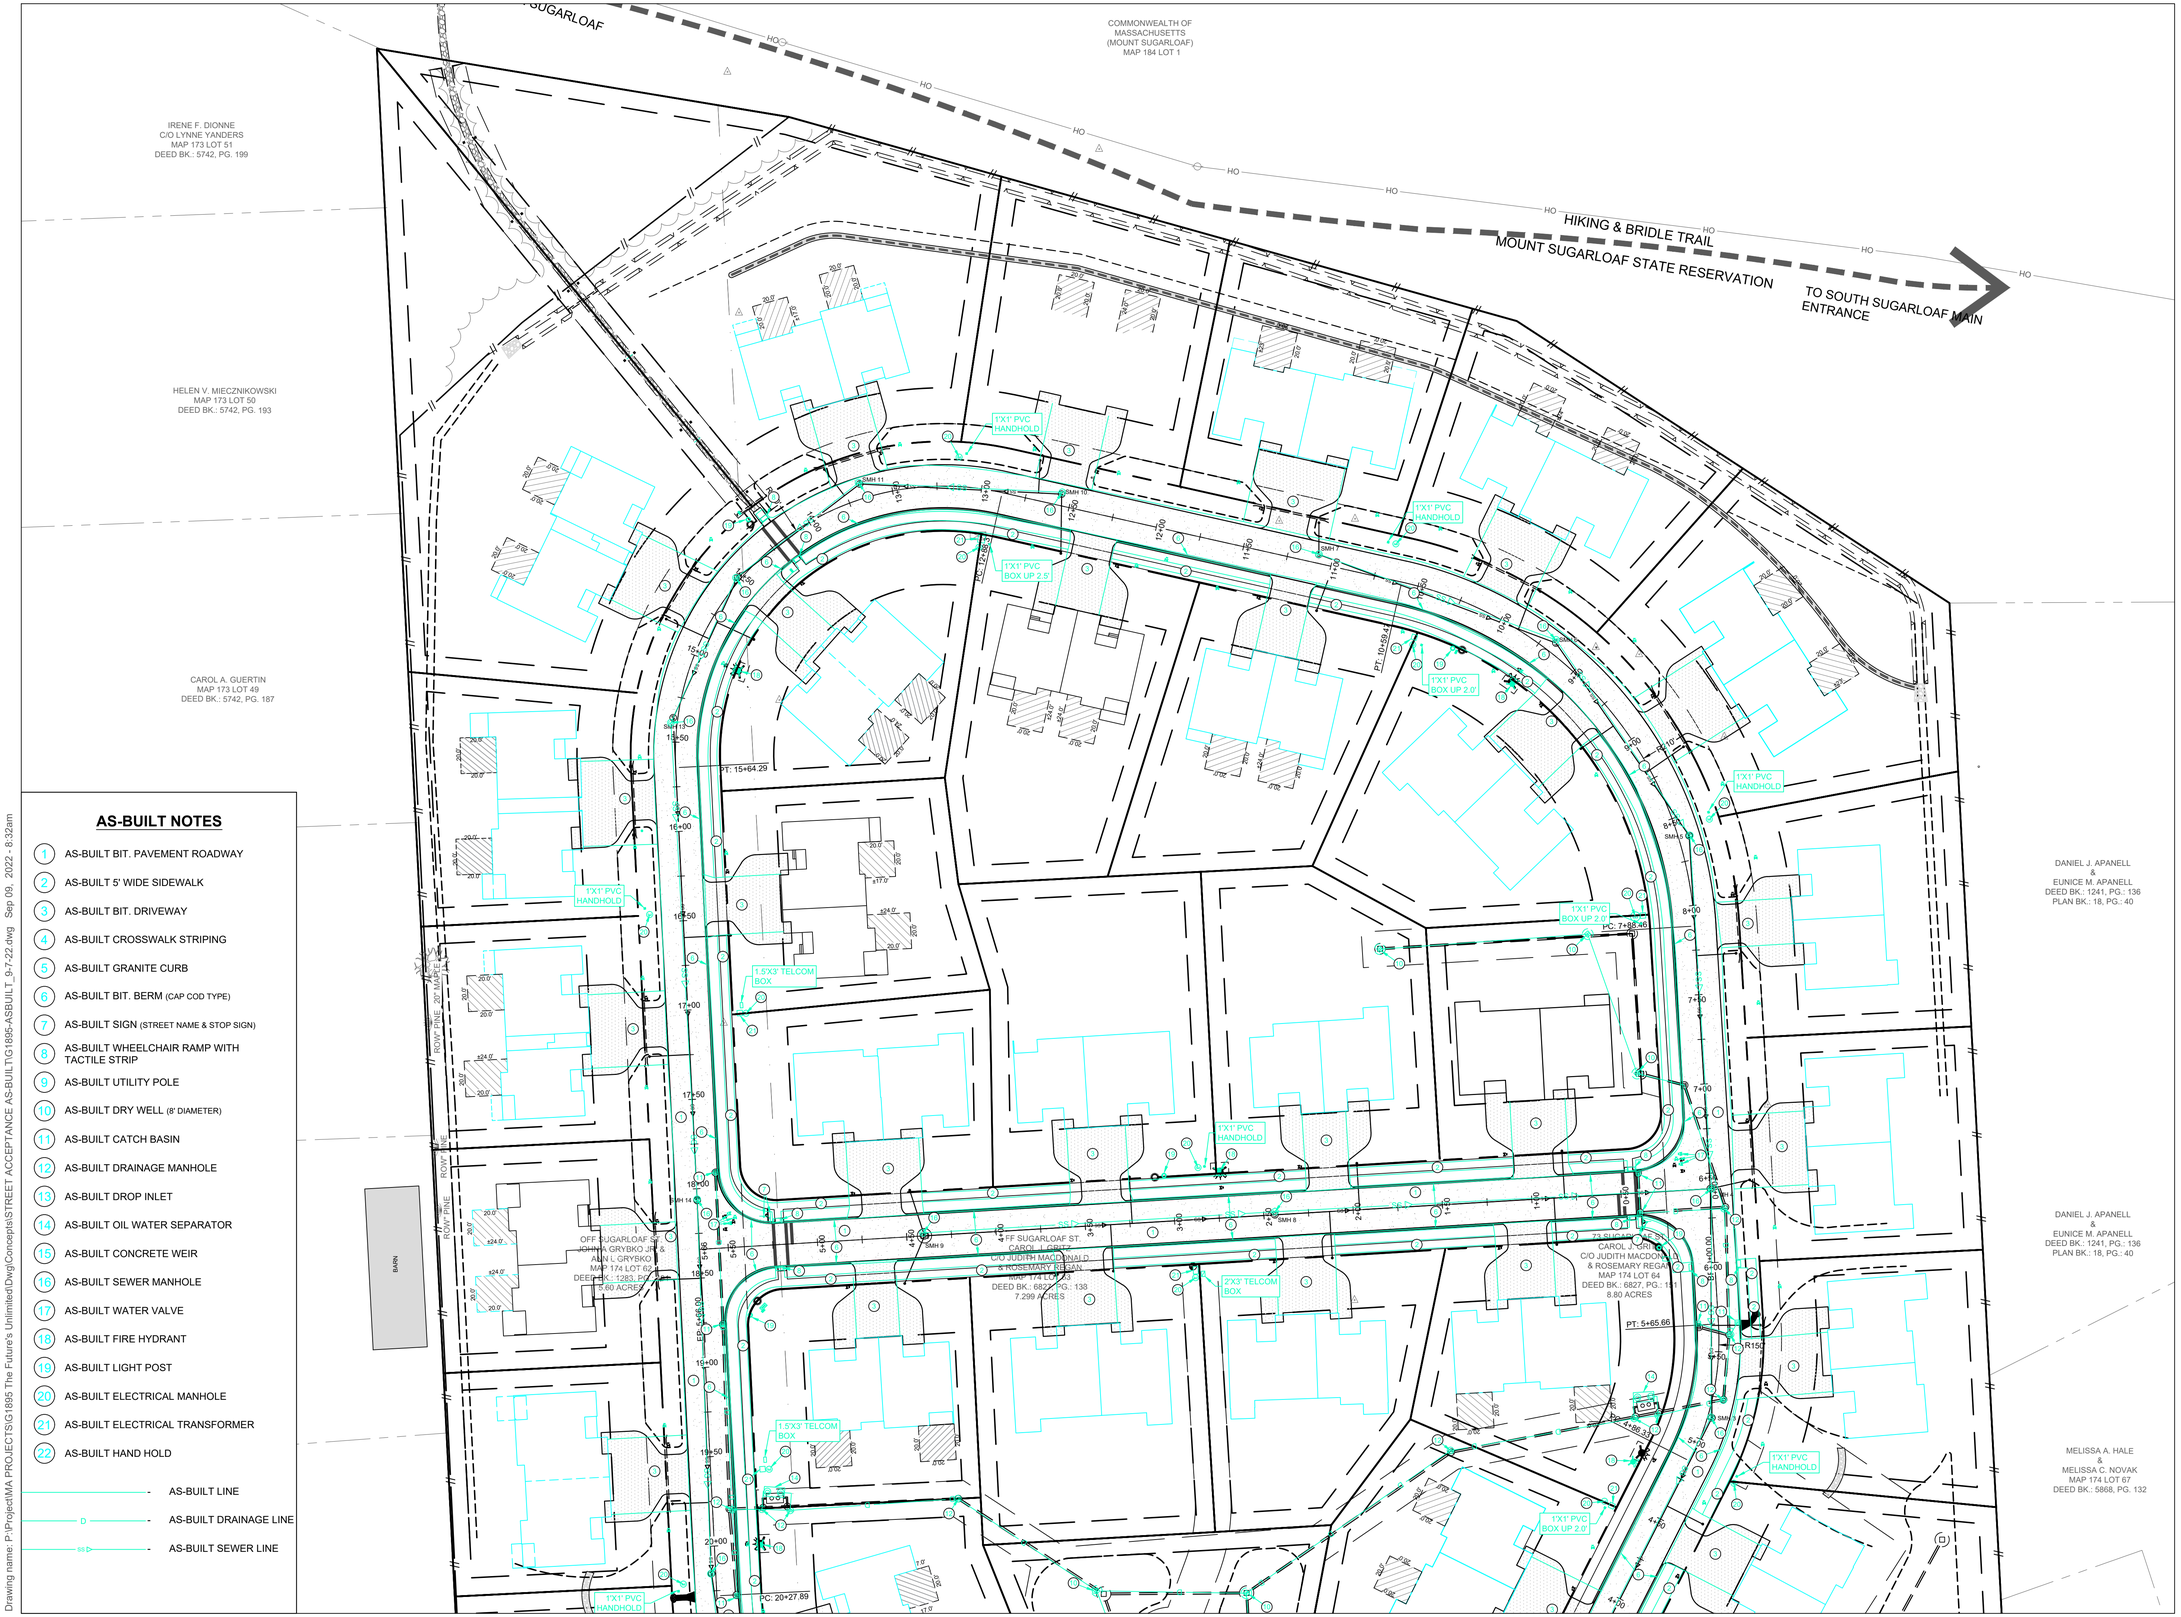

AS-BUILT NOTES

1. AS-BUILT BIT. PAVEMENT ROADWAY
2. AS-BUILT 5' WIDE SIDEWALK
3. AS-BUILT BIT. DRIVEWAY
4. AS-BUILT CROSSWALK STRIPING
5. AS-BUILT GRANITE CURB
6. AS-BUILT BIT. BERM (CAP COD TYPE)
7. AS-BUILT SIGN (STREET NAME & STOP SIGN)
8. AS-BUILT WHEELCHAIR RAMP WITH TACTILE STRIP
9. AS-BUILT UTILITY POLE
10. AS-BUILT DRY WELL (8' DIAMETER)
11. AS-BUILT CATCH BASIN
12. AS-BUILT DRAINAGE MANHOLE
13. AS-BUILT DROP INLET
14. AS-BUILT OIL WATER SEPARATOR
15. AS-BUILT CONCRETE WEIR
16. AS-BUILT SEWER MANHOLE
17. AS-BUILT WATER VALVE
18. AS-BUILT FIRE HYDRANT
19. AS-BUILT LIGHT POST
20. AS-BUILT ELECTRICAL MANHOLE
21. AS-BUILT ELECTRICAL TRANSFORMER
22. AS-BUILT HAND HOLD

- AS-BUILT LINE
- D - AS-BUILT DRAINAGE LINE
- SS - AS-BUILT SEWER LINE

Drawing name: P:\Project\MA PROJECTS\G1895 The Future's Unlimited\Dwg\Concepts\STREET ACCEPTANCE AS-BUILT\G1895-ASBUILT_9-7-22.dwg Sep 09, 2022 - 8:32am

DRAFT

NOT FOR CONSTRUCTION

NO.	REVISION	DATE	DWN	CHK

SVE ©2019

Engineering
Planning
Landscape Architecture
Surveying

SVE Associates
P.O. Box 1818
439 West River Road
Brattleboro, VT 05302
T 413.774.6698
F 413.773.0875
www.sveassoc.com

INTERIM HORIZONTAL AS-BUILT PLAN

THE CONDOMINIUMS AT SUGARLOAF

THE FUTURES UNLIMITED
7 OAK KNOLL DRIVE
SOUTH DEERFIELD, MA 01373

0 20 40 80
GRAPHIC SCALE 1" = 40'

N

PROJ. #: G1895

DATE: 8 - SEP - 22

DRAWN: MJS

SHEET 2/2